S9 - Storrs A

The height of simplicity, this fence with smooth top rail has been modified so that pickets do not extend through the bottom rail.

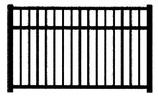

A Indicates available also in our patented ALUMINATE® screwless design in all grades.

RAILING BY: SPECRAIL

CONTRACTOR TO VERIFY ALL EXISTING CONDITIONS PRIOR TO ORDERING, FABRICATING OR INSTALLING ANY MATERIALS. FIELD CONDITIONS SHOULD BE REFLECTED IN IN ALL SHOP DRAWINGS & RECORD DRAWINGS. REPORT ANY DISCREPANCIES & COORDINATE ALL CHANGES WITH THE OWNER/ARCHITECT.

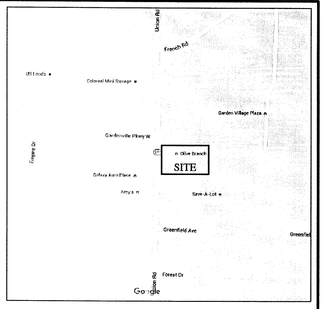

LOCATION MAP

UNION (WIDTH VARIES) ROAD

N.Y.S. ROUTE 277

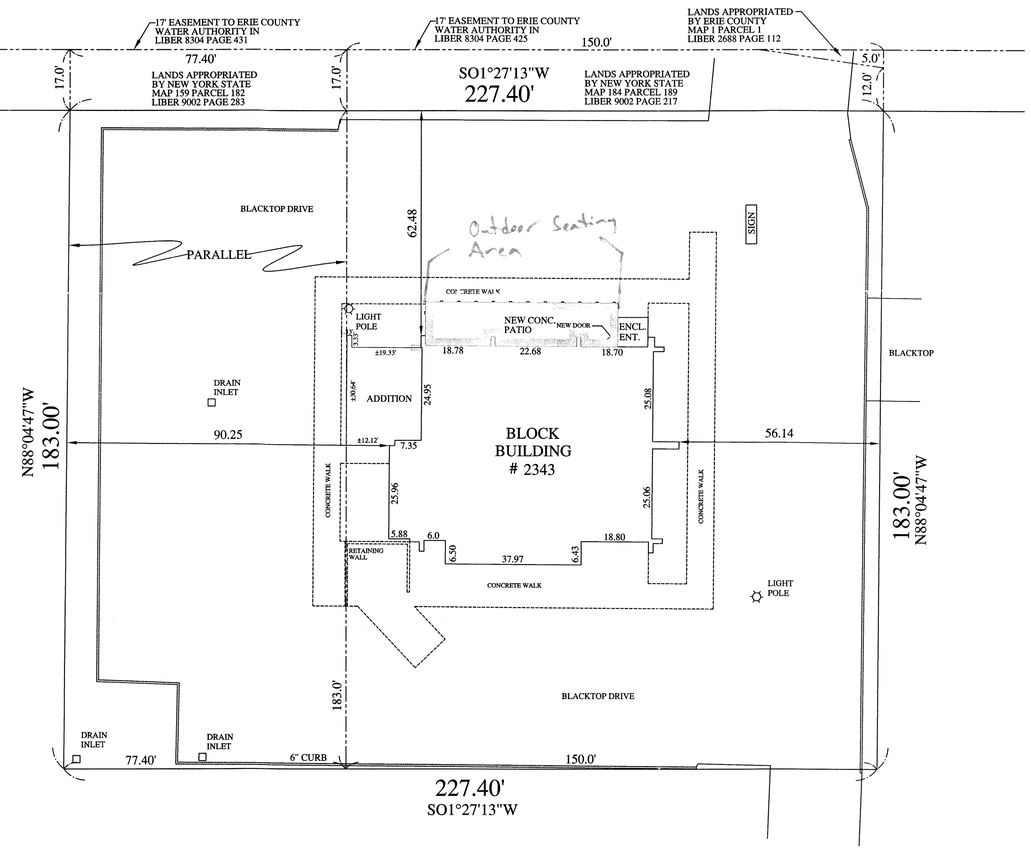

SITE PLAN

GRAPHIC SCALE

20 0 10 20 40 80

(IN FEET)
1 inch = 20 ft.

THE APPROVING ARCHITECT IS NOT RESPONSIBLE FOR THE FOLLOWING:
-SITE INSPECTIONS
-QUALITY OF WORKMANSHIP
-ANY UNAUTHORIZED CHANGES FROM THE STAMPED DRAWINGS
-APPLICATION OF DRAWINGS ON THE JOB

THESE DRAWINGS HAVE BEEN PROFESSIONALLY REVIEWED AND ADOPTED BY THE APPROVING ARCHITECT AND TO THE BEST OF HIS KNOWLEDGE THEY MEET OR EXCEED THE REQUIREMENTS OF THE BUILDING CODE NEW YORK STATE.

SUB CONTRACTORS ARE REQUIRED TO CHECK ALL DIMENSIONS AND SPECIFICATIONS PRIOR TO START OF WORK AND REPORT ANY DISCREPANCIES.

REVISIONS

PH- (716)667-1436
FAX- (716)667-0163
dmarchtecs@gmail.com

DARYL MARTIN
ARCHITECT, PC
3625 Eggert Road | Orchard Park, N.Y. 14127

SITE PLAN

NEW PATIO for:
THE OLIVE BRANCH RESTAURANT
2343 UNION ROAD
WEST SENECA, NEW YORK

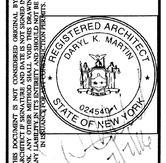

THIS DOCUMENT IS NOT CONSIDERED ORIGINAL BY THE ARCHITECT IF SIGNATURE AND DATE IS NOT SIGNED IN RED INK. ANY OTHER METHOD SHALL VOID THIS DRAWING OF ANY LIABILITY IN ITS ENTIRETY AND SHOULD NOT BE USED IN SUBJECT TO CONSTRUCTION PERMITS.

7/7/16

DATE:	7/7/2016
SCALE:	AS NOTED
DRAWN:	SCG
CHECKED:	DKM

ST-1

SHEET NUMBER